



PLANTA
ESCALA 1:2000

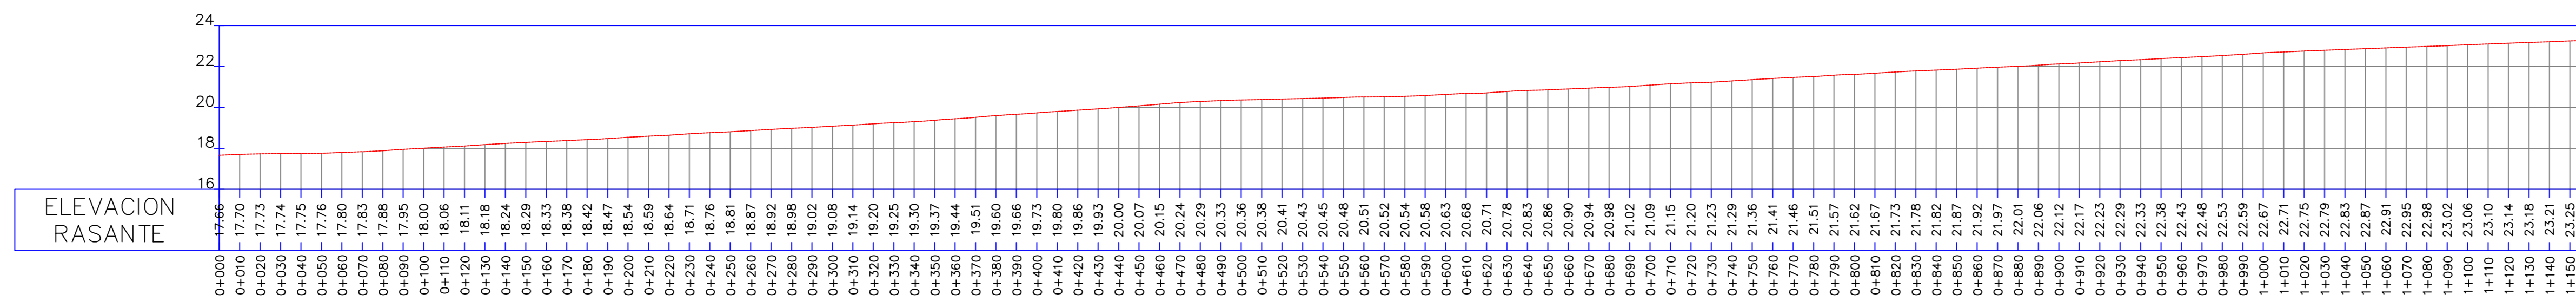

PERFIL LONGITUDINAL DE PISTA
ESCALA 1:2000

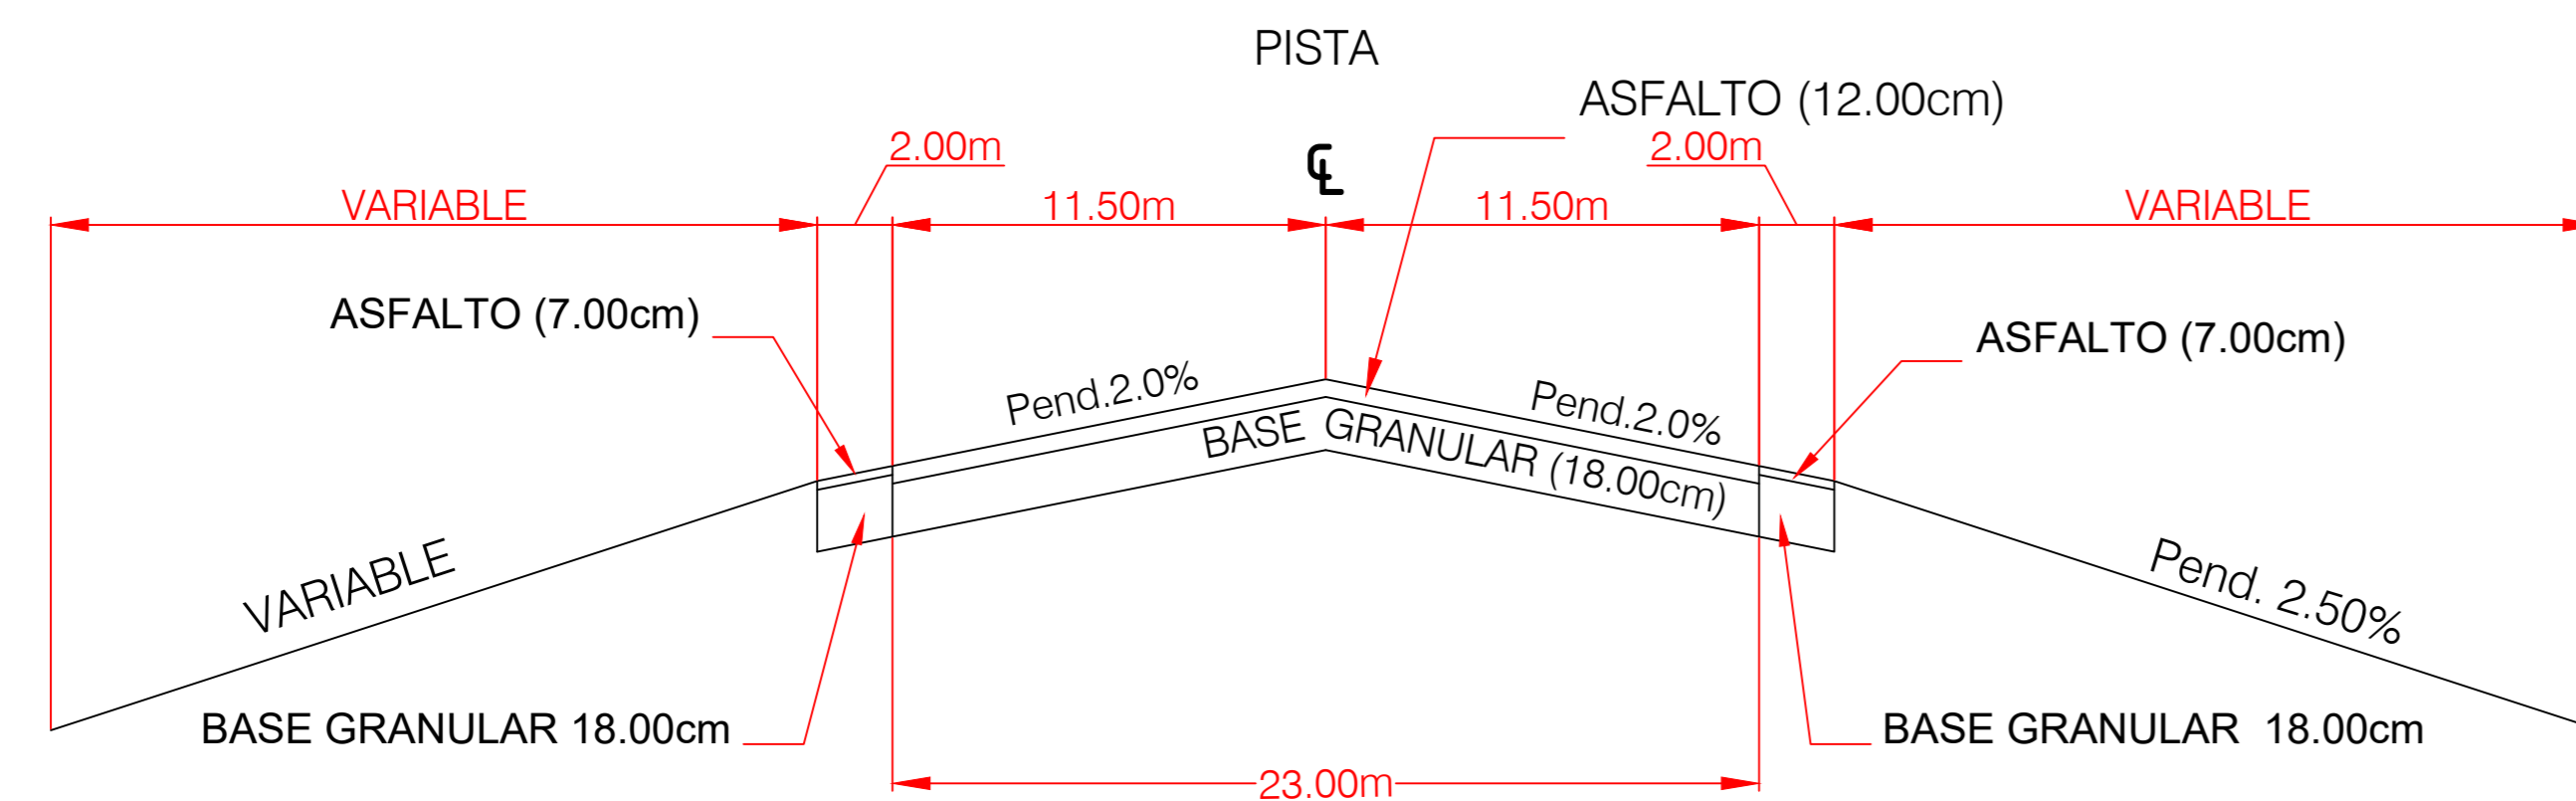

SECCIÓN TÍPICA PISTA
SIN ESCALA

COORDENADAS DE MOJONES				
PUNTO	NORTE(m)	ESTE (m)	ELEVACION (m)	DESCRIPCION
692	1044644.680	486220.968	22.410	QP5 NUEVO
694	1044233.984	485792.210	20.331	A-4
697	1043679.050	485399.493	19.004	REF-2
698	1043717.207	485348.961	19.216	REF-1
3730	1044186.327	485835.614	19.792	CH-1
3731	1044009.226	485582.317	18.461	CH-2
3998	1044530.561	486111.820	22.146	CH-3
4008	1043821.307	485440.466	17.577	Aux-20

COMO CONSTRUIDO

PROYECTO
MEJORAMIENTO AERÓDROMO DE QUEPOS
PLANOS COMO CONSTRUIDO

INFORMACION REGISTRO PUBLICO
No. DE CATASTRO: P-1636614-2013
FOLIO REAL: 6206736-000
PROPIETARIO: CONSEJO TECNICO DE AVIACION CIVIL

CONTENIDO
INDICADO

